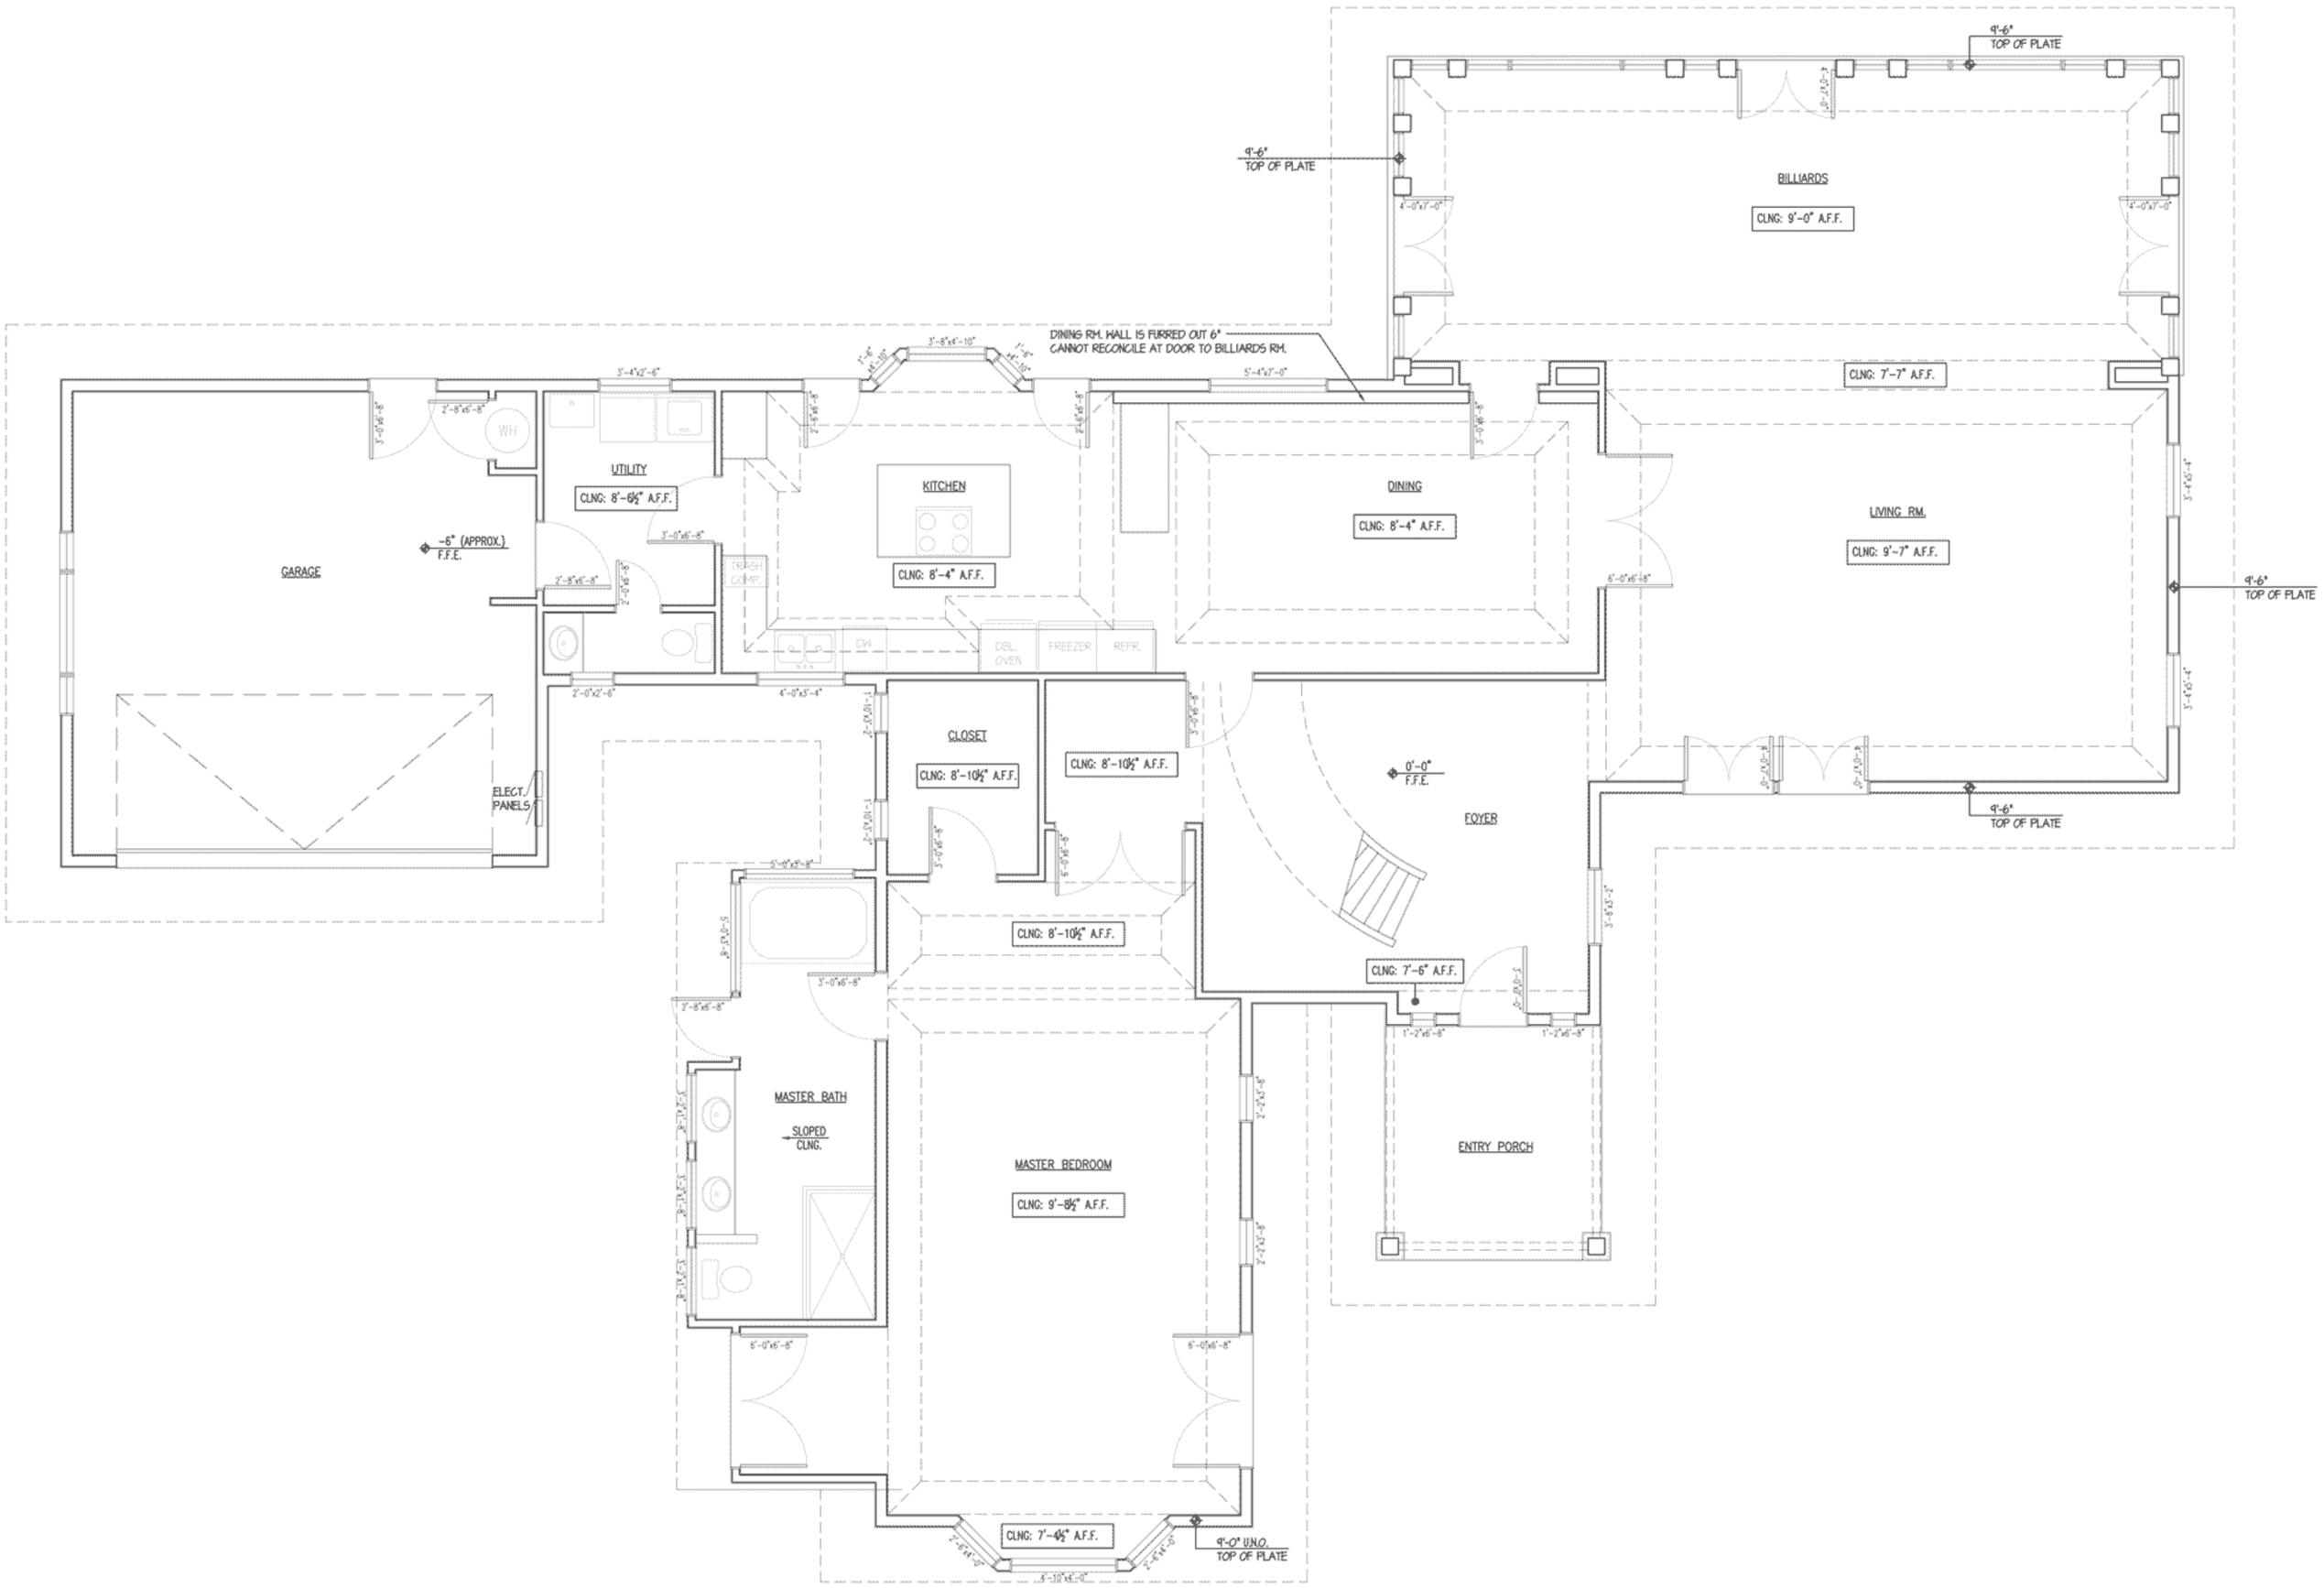

MAIN HOUSE- LOWER LEVEL PLAN
1/4"=1'-0"

MAIN HOUSE- UPPER FLOOR PLAN
1/4"=1'-0"

COGENT DESIGNS
808.652.0105 PO BOX 617 KAPAA HI 96746

THIS WORK WAS PREPARED BY ME OR UNDER MY SUPERVISION AND CONSTRUCTION OF THIS PROJECT WILL BE UNDER MY OBSERVATION.

Project Title:

DOLPHIN HOUSE

AS-BUILTS

Drawing Title

Revisions:

No	Description	Date

TMK #

Architect's Project #: 0609

Date: 10 OCTOBER 2006

Scale:

Drawing No.:

SHEET: OF